
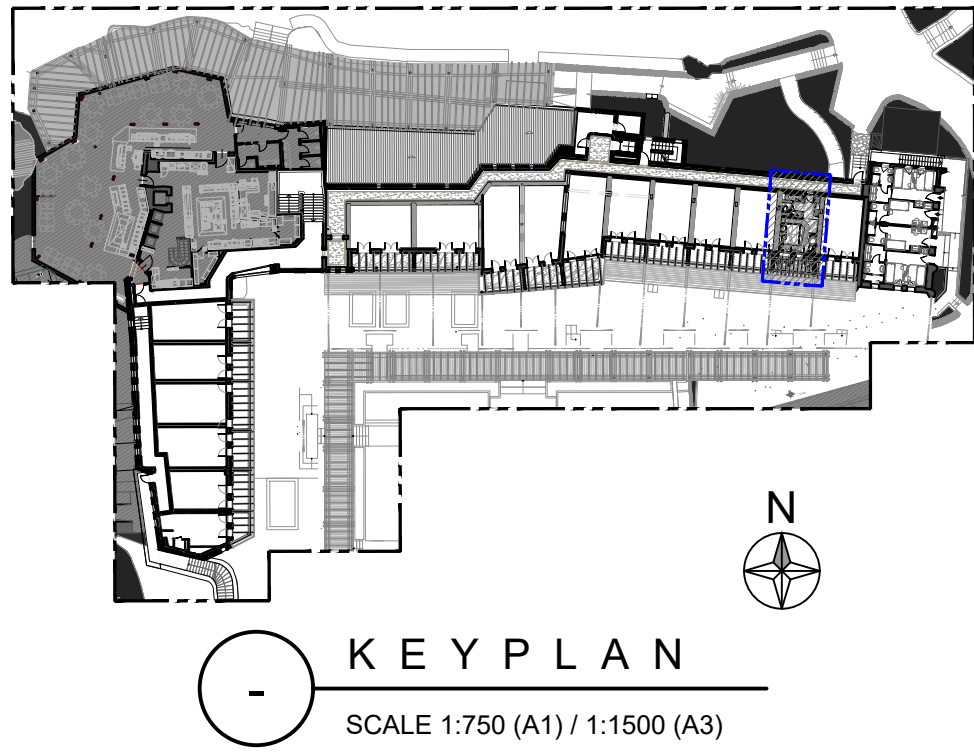
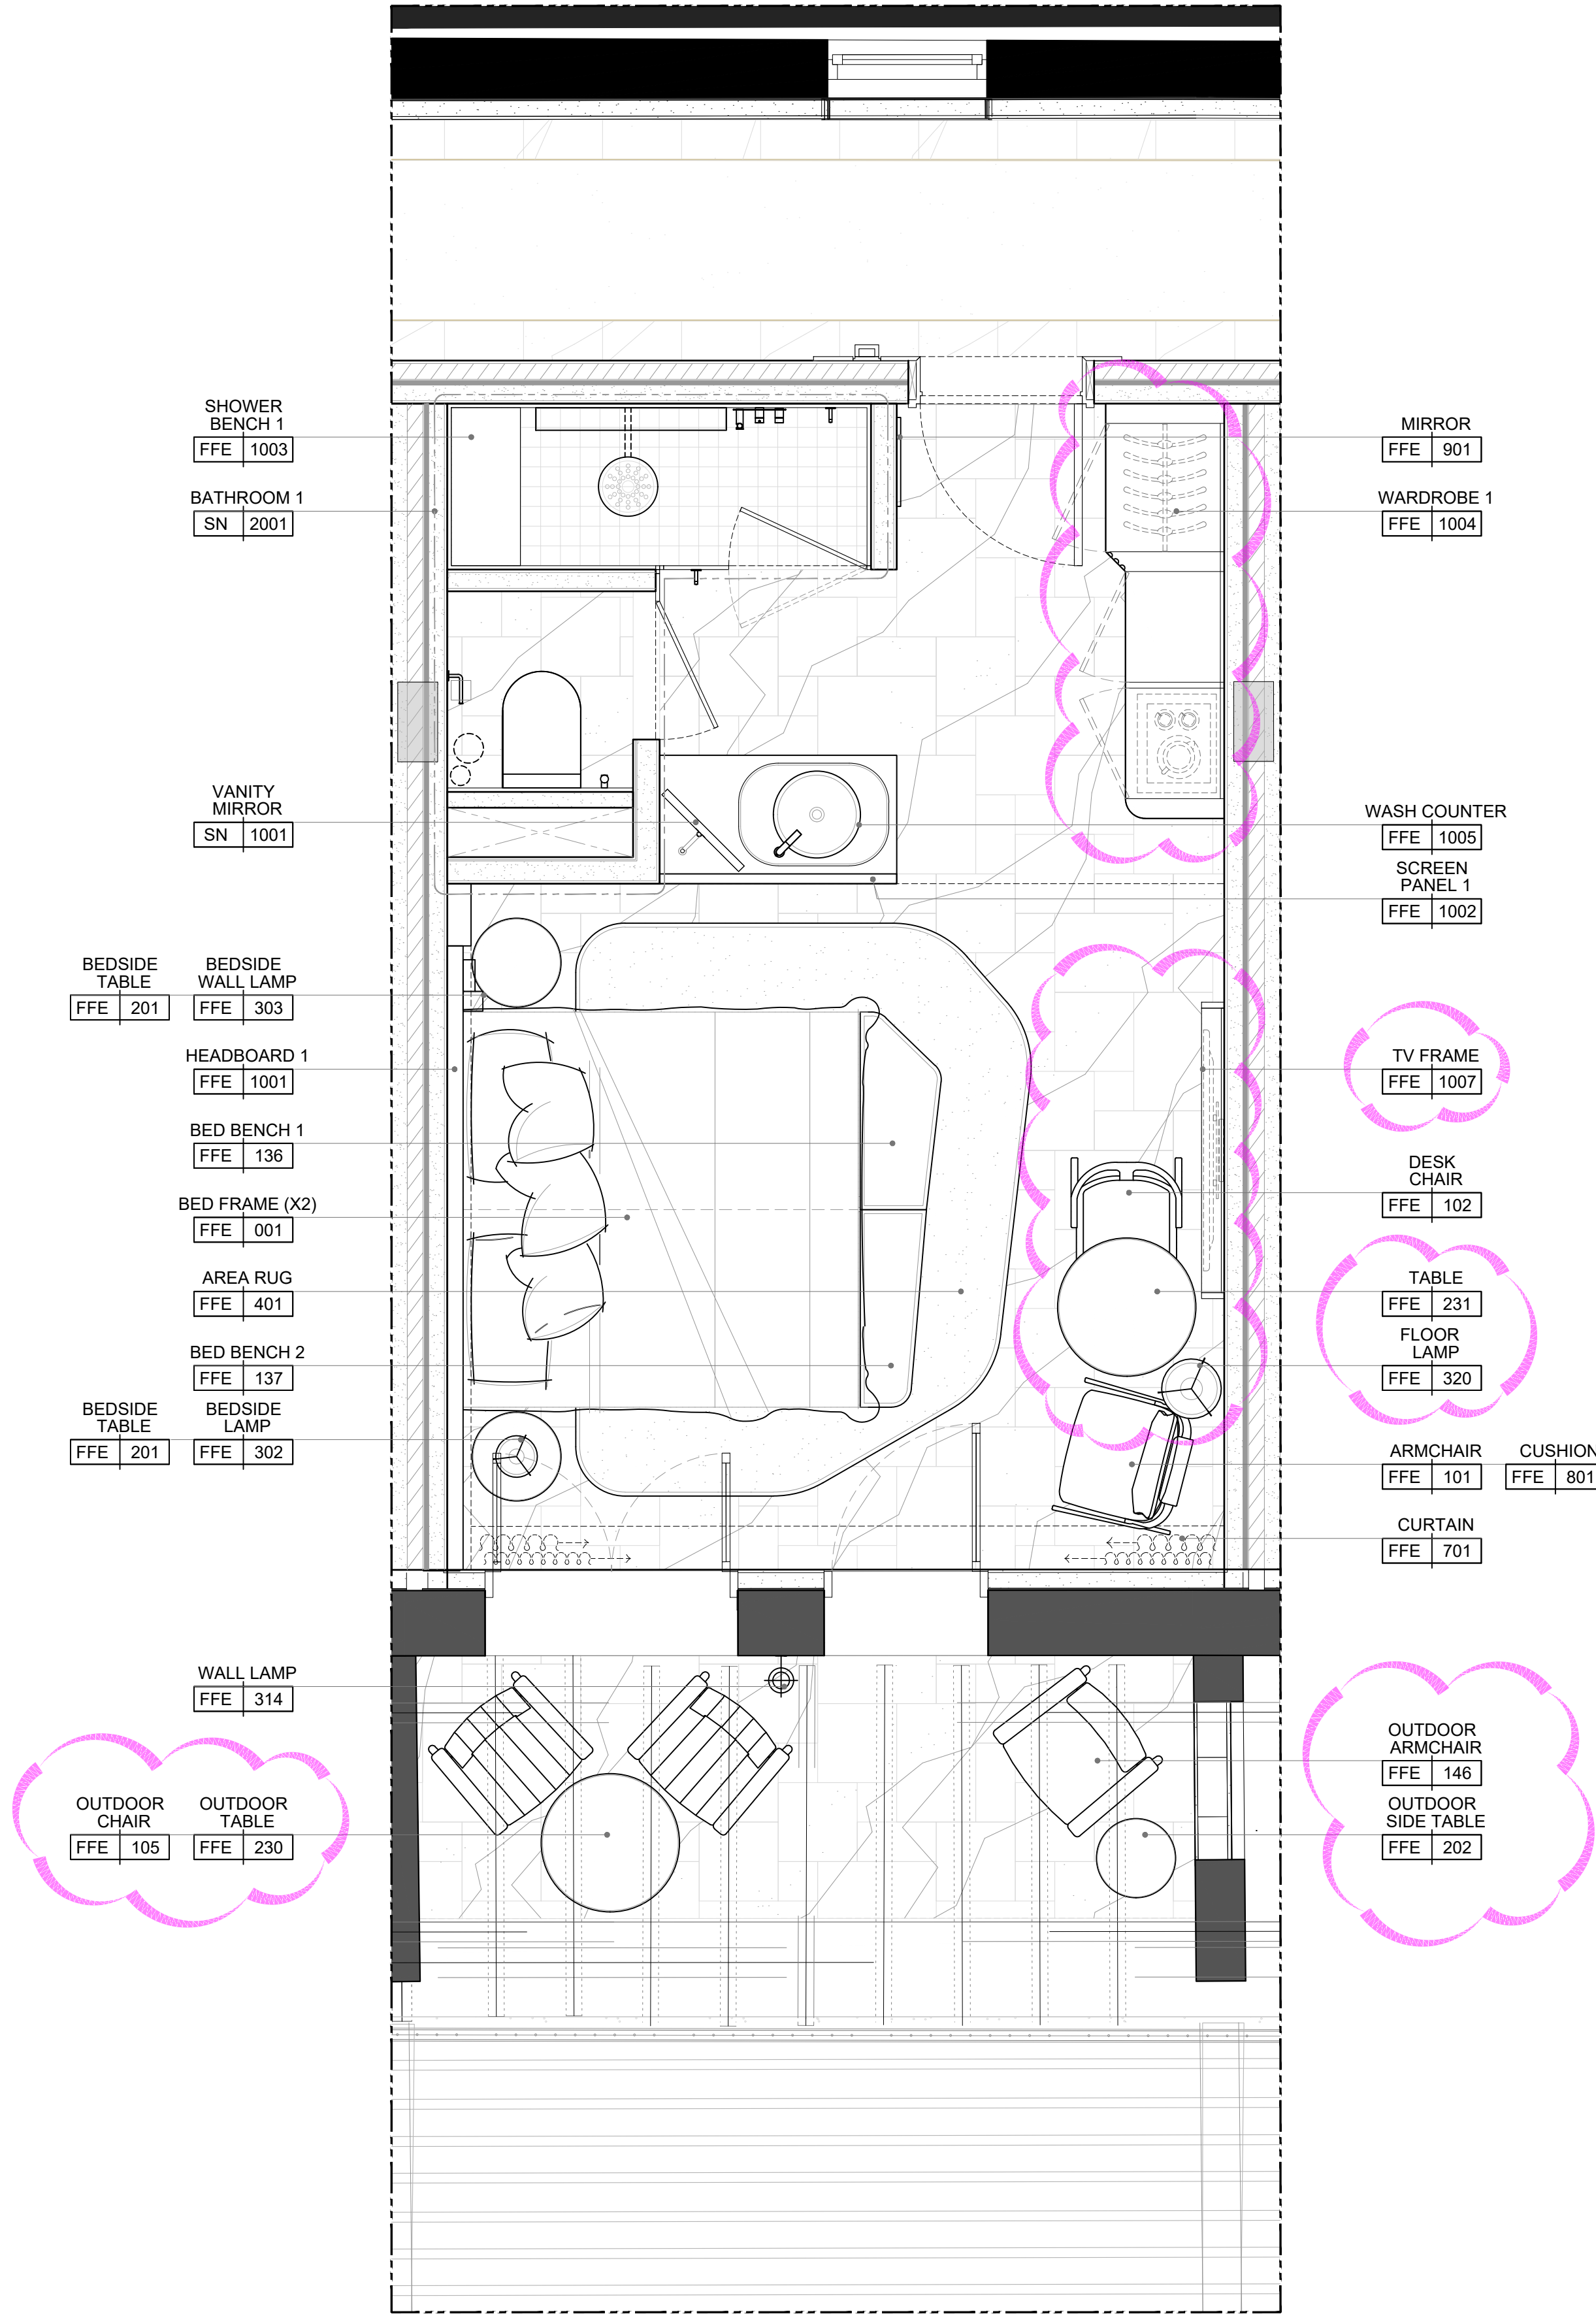


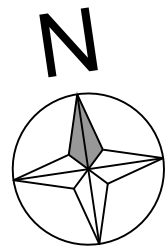

GENERAL NOTES

DO NOT TAKE MEASUREMENT DIRECTLY ON THE DRAWING. ANY DISCREPANCY BETWEEN THIS DRAWING AND OTHER INFORMATION MUST BE REPORTED TO POD ARCHITECTURE. FOR UNDER CONSTRUCTION OR EXISTING BUILDING, CONTRACTOR IS REQUIRED TO VERIFY THE CORRESPONDENCE BETWEEN THE REAL DIMENSIONS POINTED ON SITE AND THOSE LISTED ON THE DRAWING. IN CASE OF DISCREPANCY BETWEEN THIS DRAWING AND APPROVED DRAWINGS OF SUBCONTRACTOR, SUBCONTRACTOR'S DRAWINGS ARE PRIORITY. CONFLICT ARISING OUT OF THE INFORMATION AS INDICATED ABOVE MUST BE REPORTED IMMEDIATELY TO POD ARCHITECTURE. THIS DRAWING IS THE INTELLECTUAL PROPERTY OF POD ARCHITECTURE. DIMENSIONS ARE IN MILLIMETERS UNLESS OTHERWISE STATED.

NOTE:

ALL GENERAL DIMENSIONS ARE INDICATIVE ONLY. PLEASE REFER TO EXISTING SITE TO CHECK IF GIVEN DIMENSIONS ARE APPLICABLE. ADJUST TO FIT WHEN NECESSARY.

01 FURNITURE PLAN - KING BED LAYOUT

SCALE 1:25 (A1) / 1:50 (A3)

Proprietà Smeralda Holding Smeralda Holding Srl Casa Il Ginepro 1/a, 07021, Porto Cervo (OT)	Project Management CUSHMAN & WAKEFIELD Cushman & Wakefield Via Filippo Turati, 10/18, 20121, Milano Arch. Benedetta Albottori Arch. Gianluca Di Cristofaro	Architect LEV Arch Lev arch srl Via Boccaccio 29 20123 Milano Arch. Luca Colombo	Local Architect - Structural Engineer Studio Ingegneria Cannas Via Georgia - Geocity torre 3, 07026, Olbia (SS) Ing. Danilo Cannas	Fire - Acoustic Consultant Italmonte s.r.l. Via Belforte, 107/a, 10149, Torino Arch. Emanuela Pignatelli Ordine Architetti di Torino n. T044836A01207	System Engineer BRE engineering s.r.l. Via Benozzi, 6, 20122, Milano Ing. Antonio Abramo Bazzoni Regazzini Ordine Ingegneri di Milano n. 24543	Interior Designer ATELIER POD Atelier POD 301 JLT Dubai UAE, PO 337418, Tel 0442127701 Laurine Higeli Javier Luc Delar
--	---	--	---	---	--	---

Le basi del disegno derivano dai seguenti documenti: *Tennis club drawings starting points are Base grafica degli esterni: Rilievo del 2004; Exterior drawings: 2004 Survey; Base grafica dell'edificio: Stato di Fatto Ing. Cannas del 17/07/2023; Building drawings: 17/07/2023 As Built from Ing. Cannas; Base grafica di quote e info interne all'edificio: Sanatoria Ing. Cannas del 23/07/2022 e rilievo 09/2023 Interior and exterior levels: 23/07/2022 amnesty from Ing. Cannas + 09/2023 survey*
NB. Le quote di livello del rilievo 2004 (xxx) differiscono dalle ultime del rilievo 2023 (xxx) di circa 1,30mt Levels from 2004 survey (xxx) and the last from 2023 survey (xxx) differs by 1,30mt



MOCK-UP ROOM DETAIL DESIGN
First Floor Guestroom 103

Project
Cervo Tennis Club
Municipality
Arzachena
Site
Via Porto Vecchio, 4
Porto Cervo 07021

Sheet Title
GUESTROOM MUR FURNITURE PLAN
Scale
AS SHOWN
No. Drawing
CTC_MOC_ID_PJ_300_A1

digital file index
CTC_MOC_ID_PJ_300_A1 King Plans.dwg
Date
2024.02.20
Format
A1

Revision	date	description	drawn	checked	approved
A	2024.02.20	DD P1 - FIRST ISSUE	LH	KM	-
B	2024.03.01	DD P1 - SECOND ISSUE	LH	KM	-
C	2024.03.22	DD P1 - THIRD ISSUE	LH	KM	-
D	2024.05.03	DD P1 - FOURTH ISSUE	LH	KM	-
E	2024.09.27	DD P1 - FIFTH ISSUE	LH	KM	-

ATELIER
POD
Dubai-Paris-Casablanca
www.atelierpod.com

Legend

Keyplan

