
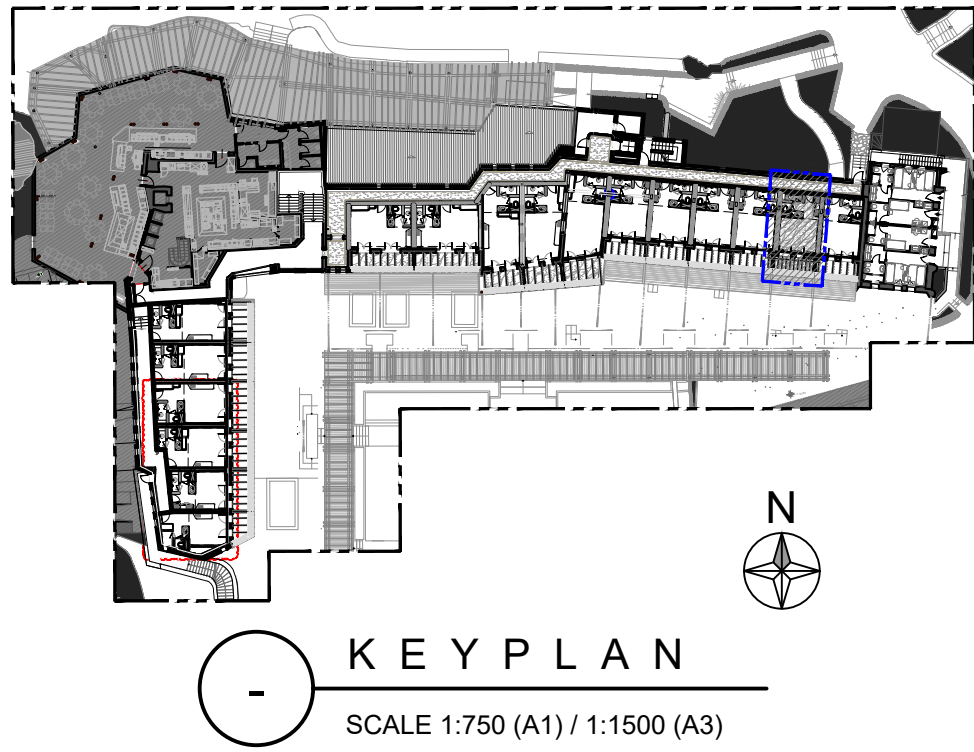
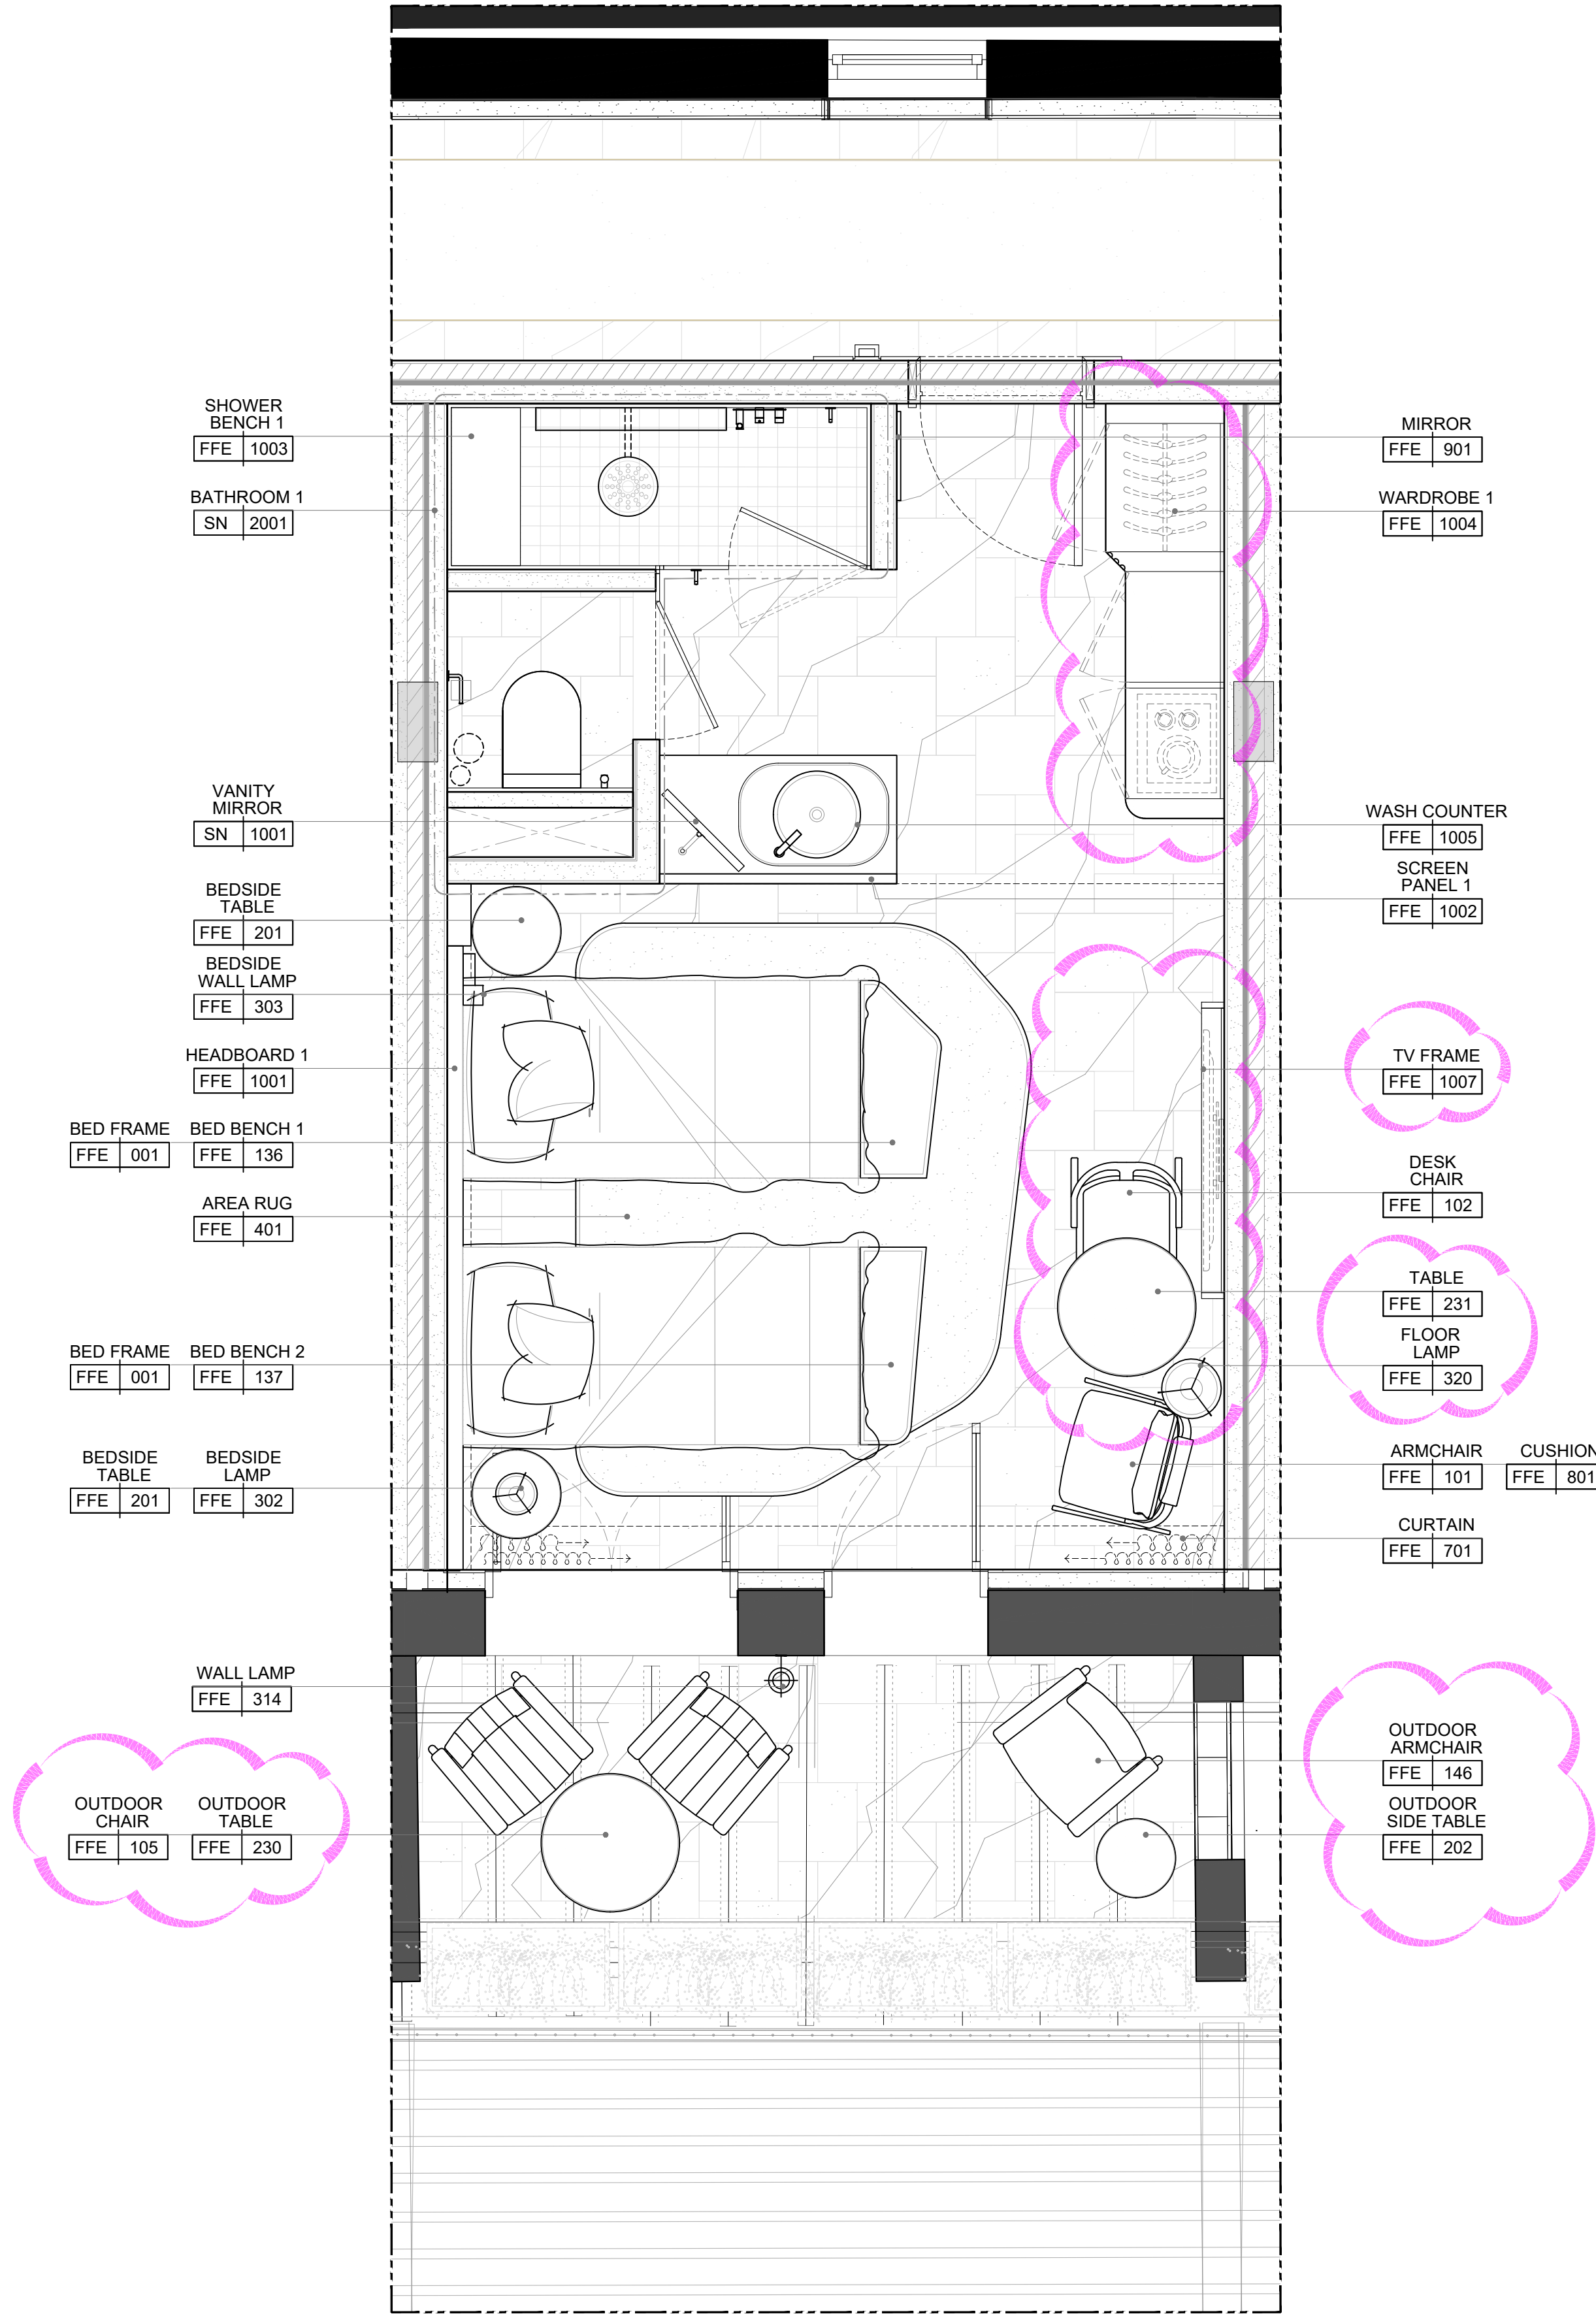


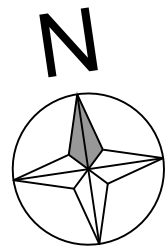

GENERAL NOTES

DO NOT TAKE MEASUREMENT DIRECTLY ON THE DRAWING. ANY DISCREPANCY BETWEEN THIS DRAWING AND OTHER INFORMATION MUST BE REPORTED TO POD ARCHITECTURE. FOR UNDER CONSTRUCTION OR EXISTING BUILDING, CONTRACTOR IS REQUIRED TO VERIFY THE CORRESPONDENCE BETWEEN THE REAL DIMENSIONS POINTED ON SITE AND THOSE LISTED ON THE DRAWING. IN CASE OF DISCREPANCY BETWEEN THIS DRAWING AND APPROVED DRAWINGS OF SUBCONTRACTOR, SUBCONTRACTOR'S DRAWINGS ARE PRIORITY. CONFLICT ARISING OUT OF THE INFORMATION AS INDICATED ABOVE MUST BE REPORTED IMMEDIATELY TO POD ARCHITECTURE. THIS DRAWING IS THE INTELLECTUAL PROPERTY OF POD ARCHITECTURE. DIMENSIONS ARE IN MILLIMETERS UNLESS OTHERWISE STATED.

NOTE:

ALL GENERAL DIMENSIONS ARE INDICATIVE ONLY. PLEASE REFER TO EXISTING SITE TO CHECK IF GIVEN DIMENSIONS ARE APPLICABLE. ADJUST TO FIT WHEN NECESSARY.

01 FURNITURE PLAN - DOUBLE BED LAYOUT

SCALE 1:25 (A1) / 1:50 (A3)

Proprietà
Smeralda Holding
Smeralda Holding Srl
Casa Il Ginepro 1/a,
07021, Porto Cervo (OT)

Project Management
CUSHMAN & WAKEFIELD
Cushman & Wakefield
Via Filippo Turati, 10/18, 20121, Milano
Arch. Benedetta Albottori
Arch. Gianluca Di Cristofaro

Architect
LEV | Arch
Lev arch srl
Via Boccaccio 29 20123 Milano
Arch. Luca Colombo

Local Architect - Structural Engineer
LEV | Arch
Studio Ingegneria Cannas
Via Georgia - Geocity torre 3, 07026, Olbia (SS)
Ing. Danilo Cannas

Fire - Acoustic Consultant
Acoustic
Acoustic s.r.l.
Corso Telesio, 107/a, 10149, Torino
Arch. Emanuela Pignatelli
Ordine Architetti di Torino n. TQ04836AD1207

System Engineer
BRIC engineering s.r.l.
Via Benozzi, 6, 20122, Milano
Ing. Antonio Abramo Rozzo Rognoni
Ordine Ingegneri di Milano n. 24843

Interior Designer
ATELIER POD
Atelier POD
301 JLT Dubai UAE, PO 337418, Tel 0442127701
Laurine Higeli
Javier Luc Delar

Le basi del disegno derivano dai seguenti documenti: *Tennis club drawings starting points are*
Base grafica degli esterni: Rilievo del 2004; *Exterior drawings: 2004 Survey*;
Base grafica dell'edificio: Stato di Fatto Ing. Cannas del 17/07/2023; *Building drawings: 17/07/2023 As Built from Ing. Cannas*;
Base grafica di quote e info interne all'edificio: Sanatoria Ing. Cannas del 23/07/2022 e rilievo 09/2023
Interior and exterior levels: 23/07/2022 amnesty from Ing. Cannas + 09/2023 survey
NB. Le quote di livello del rilievo 2004 (xxx) differiscono dalle ultime del rilievo 2023 (xxx) di circa 1,30mt
Levels from 2004 survey (xxx) and the last from 2023 survey (xxx) differs by 1,30mt



MOCK-UP ROOM DETAIL DESIGN
First Floor Guestroom 103

Project
Cervo Tennis Club
Municipality
Arzachena

Sheet Title
GUESTROOM MUR FURNITURE PLAN - DOUBLE LAYOUT
Scale:
AS SHOWN
No. Drawing
CTC_MOC_ID_PJ_300D_A1

digital file index
CTC_MOC_ID_PJ_300_A1 Double.dwg
Date
2024.02.20
Format
A1

Revision		date	description	drawn	checked	approved
A	2024.02.20	0001	DD P1 - FIRST ISSUE	LH	KM	-
B	2024.03.01	0002	DD P1 - SECOND ISSUE	LH	KM	-
C	2024.03.22	0003	DD P1 - THIRD ISSUE	LH	KM	-
D	2024.05.01	0004	DD P1 - FOURTH ISSUE	LH	KM	-
E	2024.09.27	0005	DD P1 - FIFTH ISSUE	LH	KM	-

ATELIER POD
Dubai-Paris-Casablanca
www.atelierpod.com