
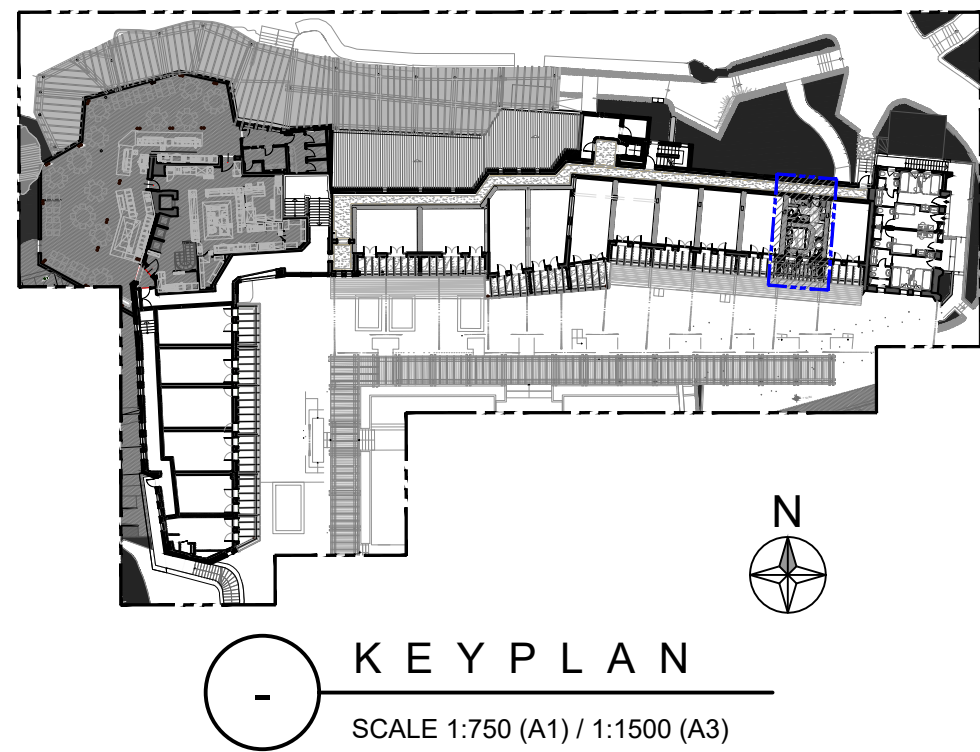


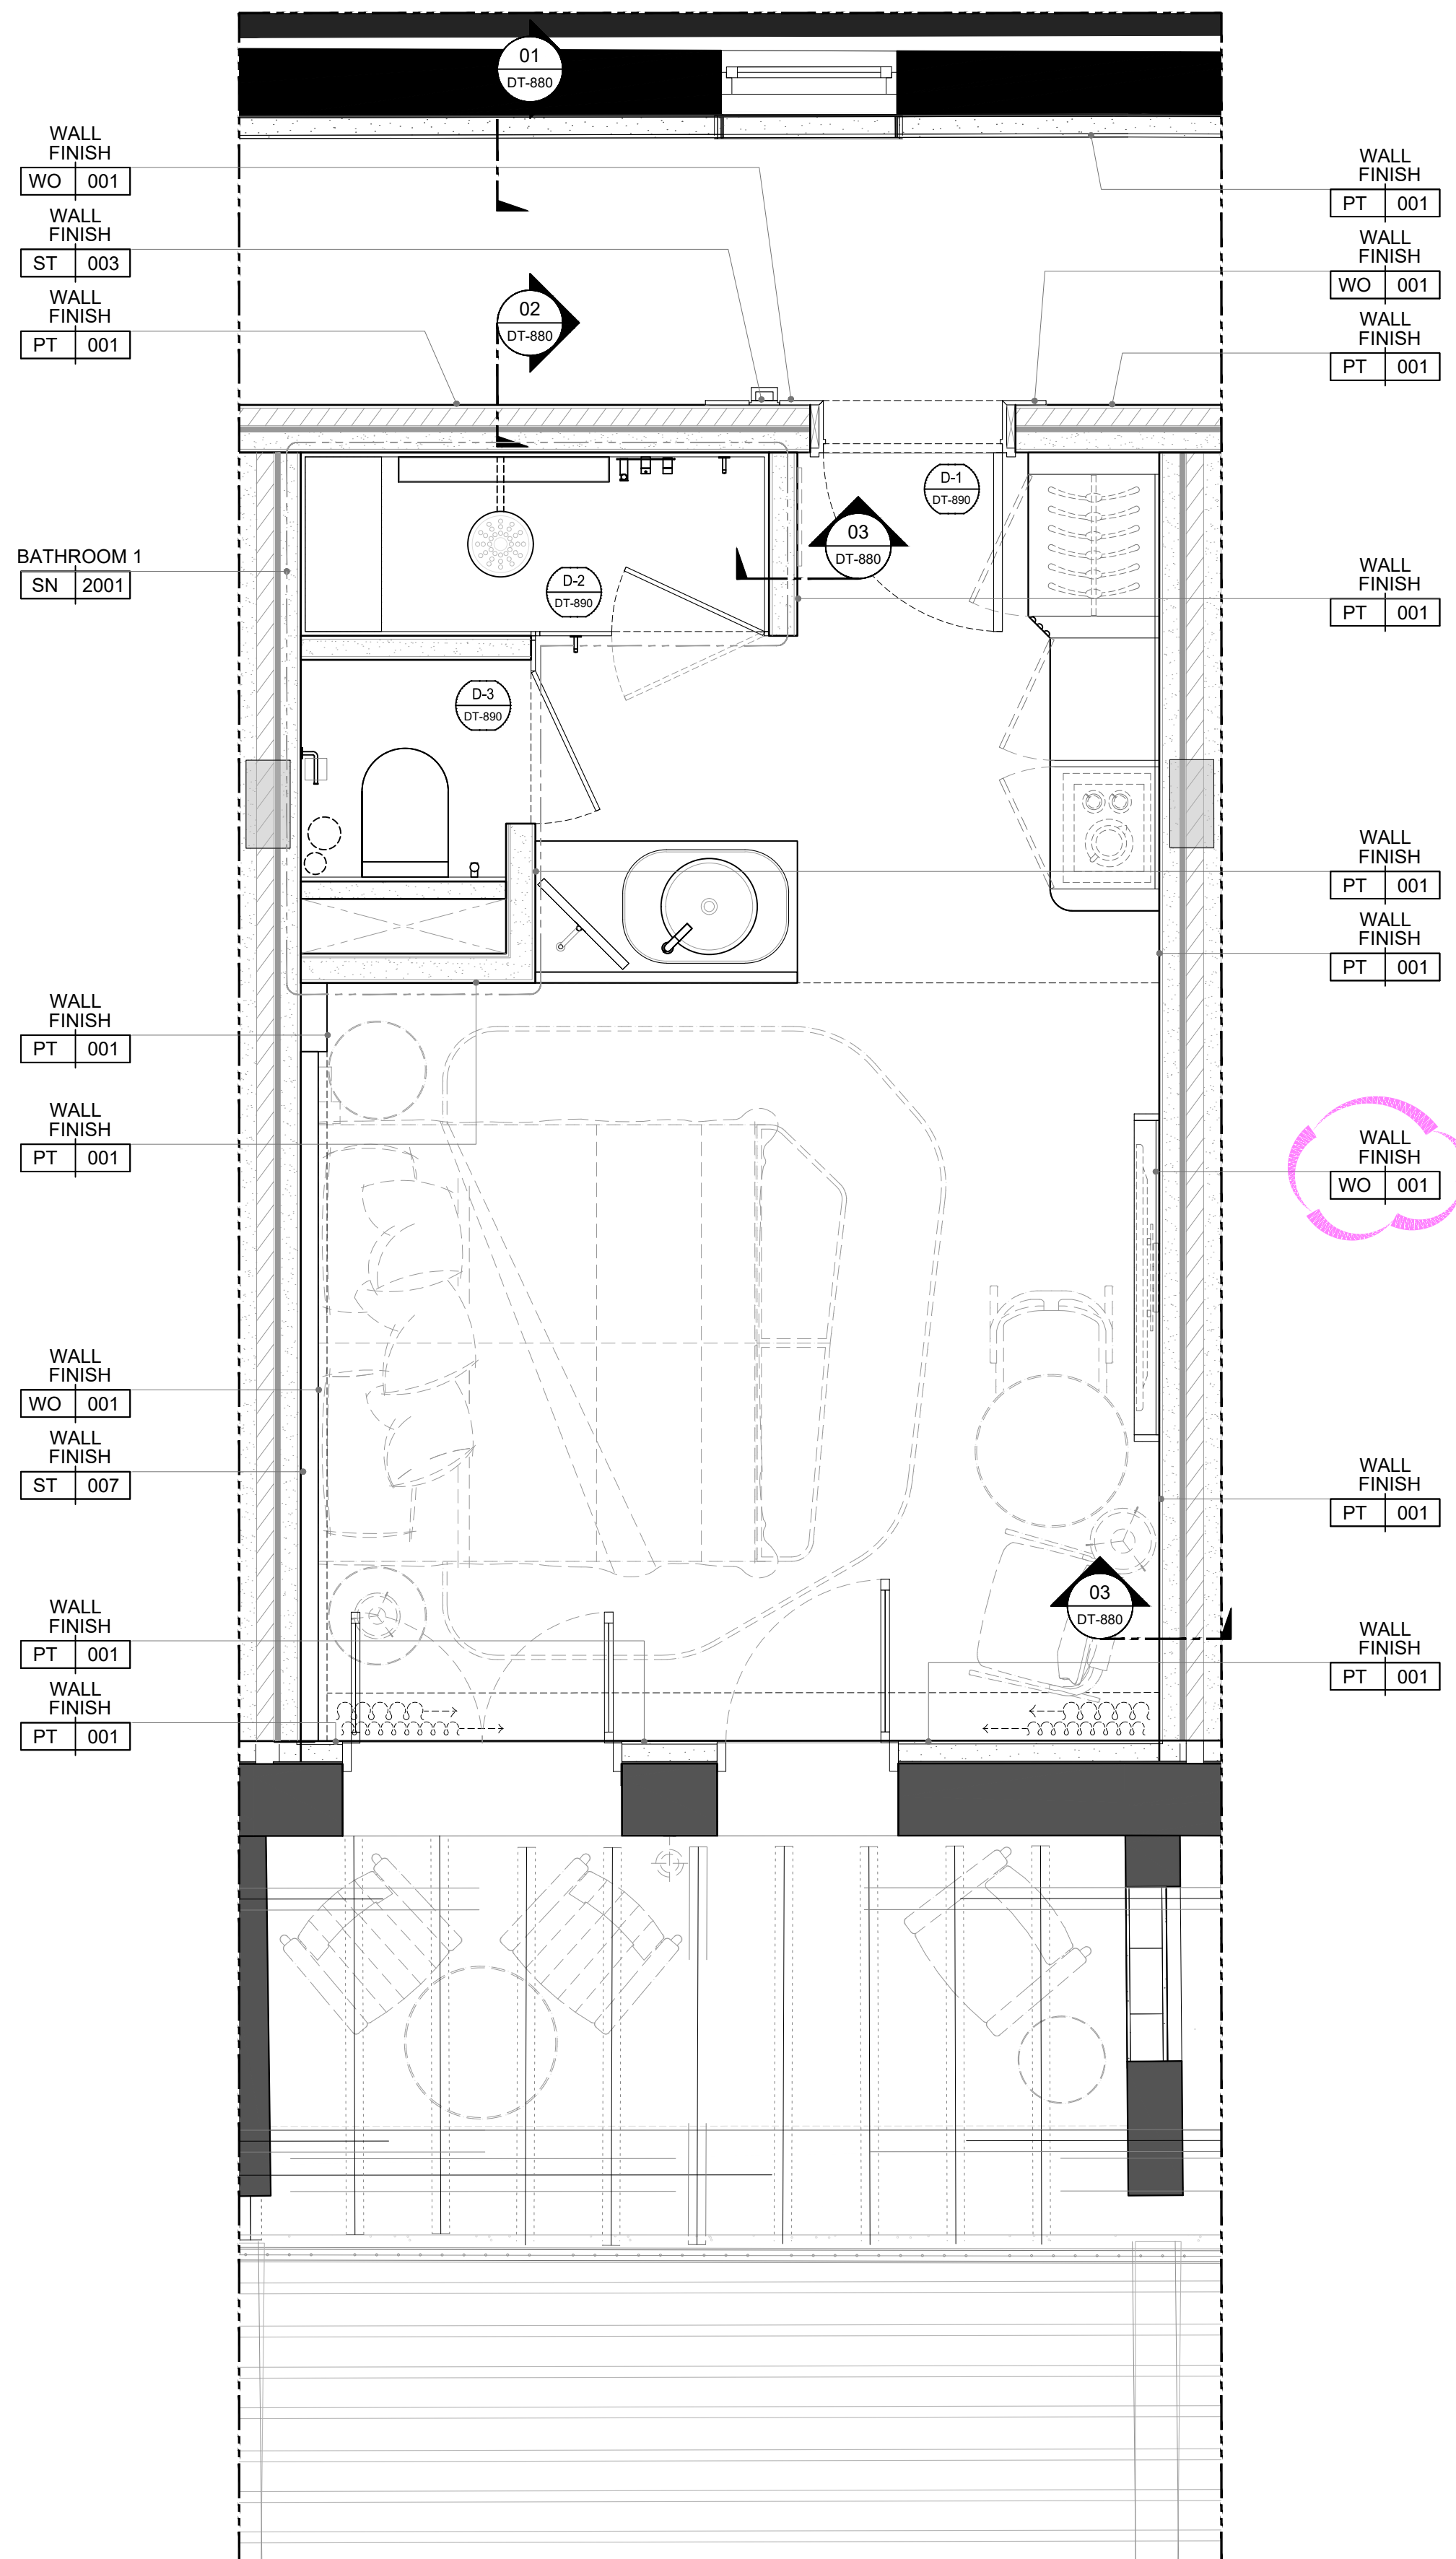

GENERAL NOTES

DO NOT TAKE MEASUREMENT DIRECTLY ON THE DRAWING. ANY DISCREPANCY BETWEEN THIS DRAWING AND OTHER INFORMATION MUST BE REPORTED TO POD ARCHITECTURE.

FOR UNDER CONSTRUCTION OR EXISTING BUILDING, CONTRACTOR IS RESPONSIBLE FOR VERIFYING THE CORRESPONDENCE BETWEEN THE REAL DIMENSIONS POINTED ON SITE AND THOSE LISTED ON THE DRAWING. IN CASE OF DISCREPANCY BETWEEN THIS DRAWING AND APPROVED DRAWINGS OF SUBCONTRACTOR, SUBCONTRACTORS DRAWINGS ARE GOVERNED.

CONFLICT ARISING OUT OF THE INFORMATION AS INDICATED ABOVE MUST BE REPORTED IMMEDIATELY TO POD ARCHITECTURE.

THIS DRAWING IS THE INTELLECTUAL PROPERTY OF POD ARCHITECTURE.

DIMENSIONS ARE IN MILLIMETERS UNLESS OTHERWISE STATED.

NOTE:
ALL GENERAL DIMENSIONS ARE
INDICATIVE ONLY. PLEASE REFER TO
EXISTING SITE TO CHECK IF GIVEN
DIMENSIONS ARE APPLICABLE.
ADJUST TO FIT WHEN NECESSARY.

SCALE 1:25 (A1) / 1:50 (A3)

Proprietà SmeraldaHolding	Project Management CUSHMAN & WAKEFIELD Cushman & Wakefield Via Filippo Turati, 16/181, 20121, Milano Arch. Benedetta Altomare 20123, Spazio Green (OT)	Architect LEV Arch Lev arch srl Via Boccaccio 29 20123 Milano Arch. Luca Colombo	Local Architect - Structural Engineer Studio Ingegneria Cerasari Via Gagarin - Geology tower, 3. 07028, Obba (SS) Ing. Danilo Cerasari	Fire - Acoustic Consultant  Ingegneria s.r.l. Corso Telemaco, 107/A - 10149, Torino Arch. Emanuela Pogliato 10121, TORINO	System Engineer  ATELIER BIRE engineering s.r.l. Via Barozzi, 6, 20122, Milano Ing. Antonio Armando Bazzani 20122, MILANO	Interior Designer ATELIER POD Atelier POD 301 JLT Dubai UAE, PO 337416, Tel 044212700 ALI Hudaib
--	---	--	--	--	--	--

Le basi del disegno derivano dai seguenti documenti: *Tennis club drawings starting points are*
Base grafica degli esterni: Rilievo del 2004; Exterior drawings: 2004 Survey;
Base grafica dell'edificio: Stato di Fatto Ing. Cannas del 17/07/2023; Building drawings: 17/07/2023 As Built from Ing. Cannas;
Base grafica di quote e info interne all'edificio: Sanatoria Ing. Cannas del 23/07/2022 e rilievo 09/2023
Interior and exterior levels: 23/07/2022 amnesty from Ing. Cannas + 09/2023 survey
NB. Le quote di livello del rilievo 2004 (xxx) differiscono dalle ultime del rilievo 2023 (xxx) di circa 1, 30mt
Levels from 2004 survey (xxx) and circa from 2023 survey (xxx) differs by 1, 30mt



MOCK-UP ROOM DETAIL DESIGN
First Floor Guestroom 103

Project
Cervo Tennis Club
Municipality
Arzachena
Site
Via Porto Vecchio,
Porto Cervo 07022

Sheet Title
**GUESTROOM MUR
WALL FINISH PLAN**
Scale
AS SHOWN
No. Drawing
CTC_MOC_ID_PJ_301_A1

digital file index

Date	Form
2024.03.30	A1

Date	Form
2024.03.30	A1

Revision						
index	date	status	design	control	approval	
A	2024.02.20	DD P1 - FIRST ISSUE	LH	KM	-	
B	2024.03.01	DD P1 - SECOND ISSUE	LH	KM	-	
C	2024.03.22	DD P1 - THIRD ISSUE	LH	KM	-	
D	2024.05.03	DD P1 - FOURTH ISSUE	LH	KM	-	
E	2024.09.27	DD P1 - FIFTH ISSUE	LH	KM	-	

ATELIER
POD
Dubai-Paris-Casablanca
www.atelierpod.com