



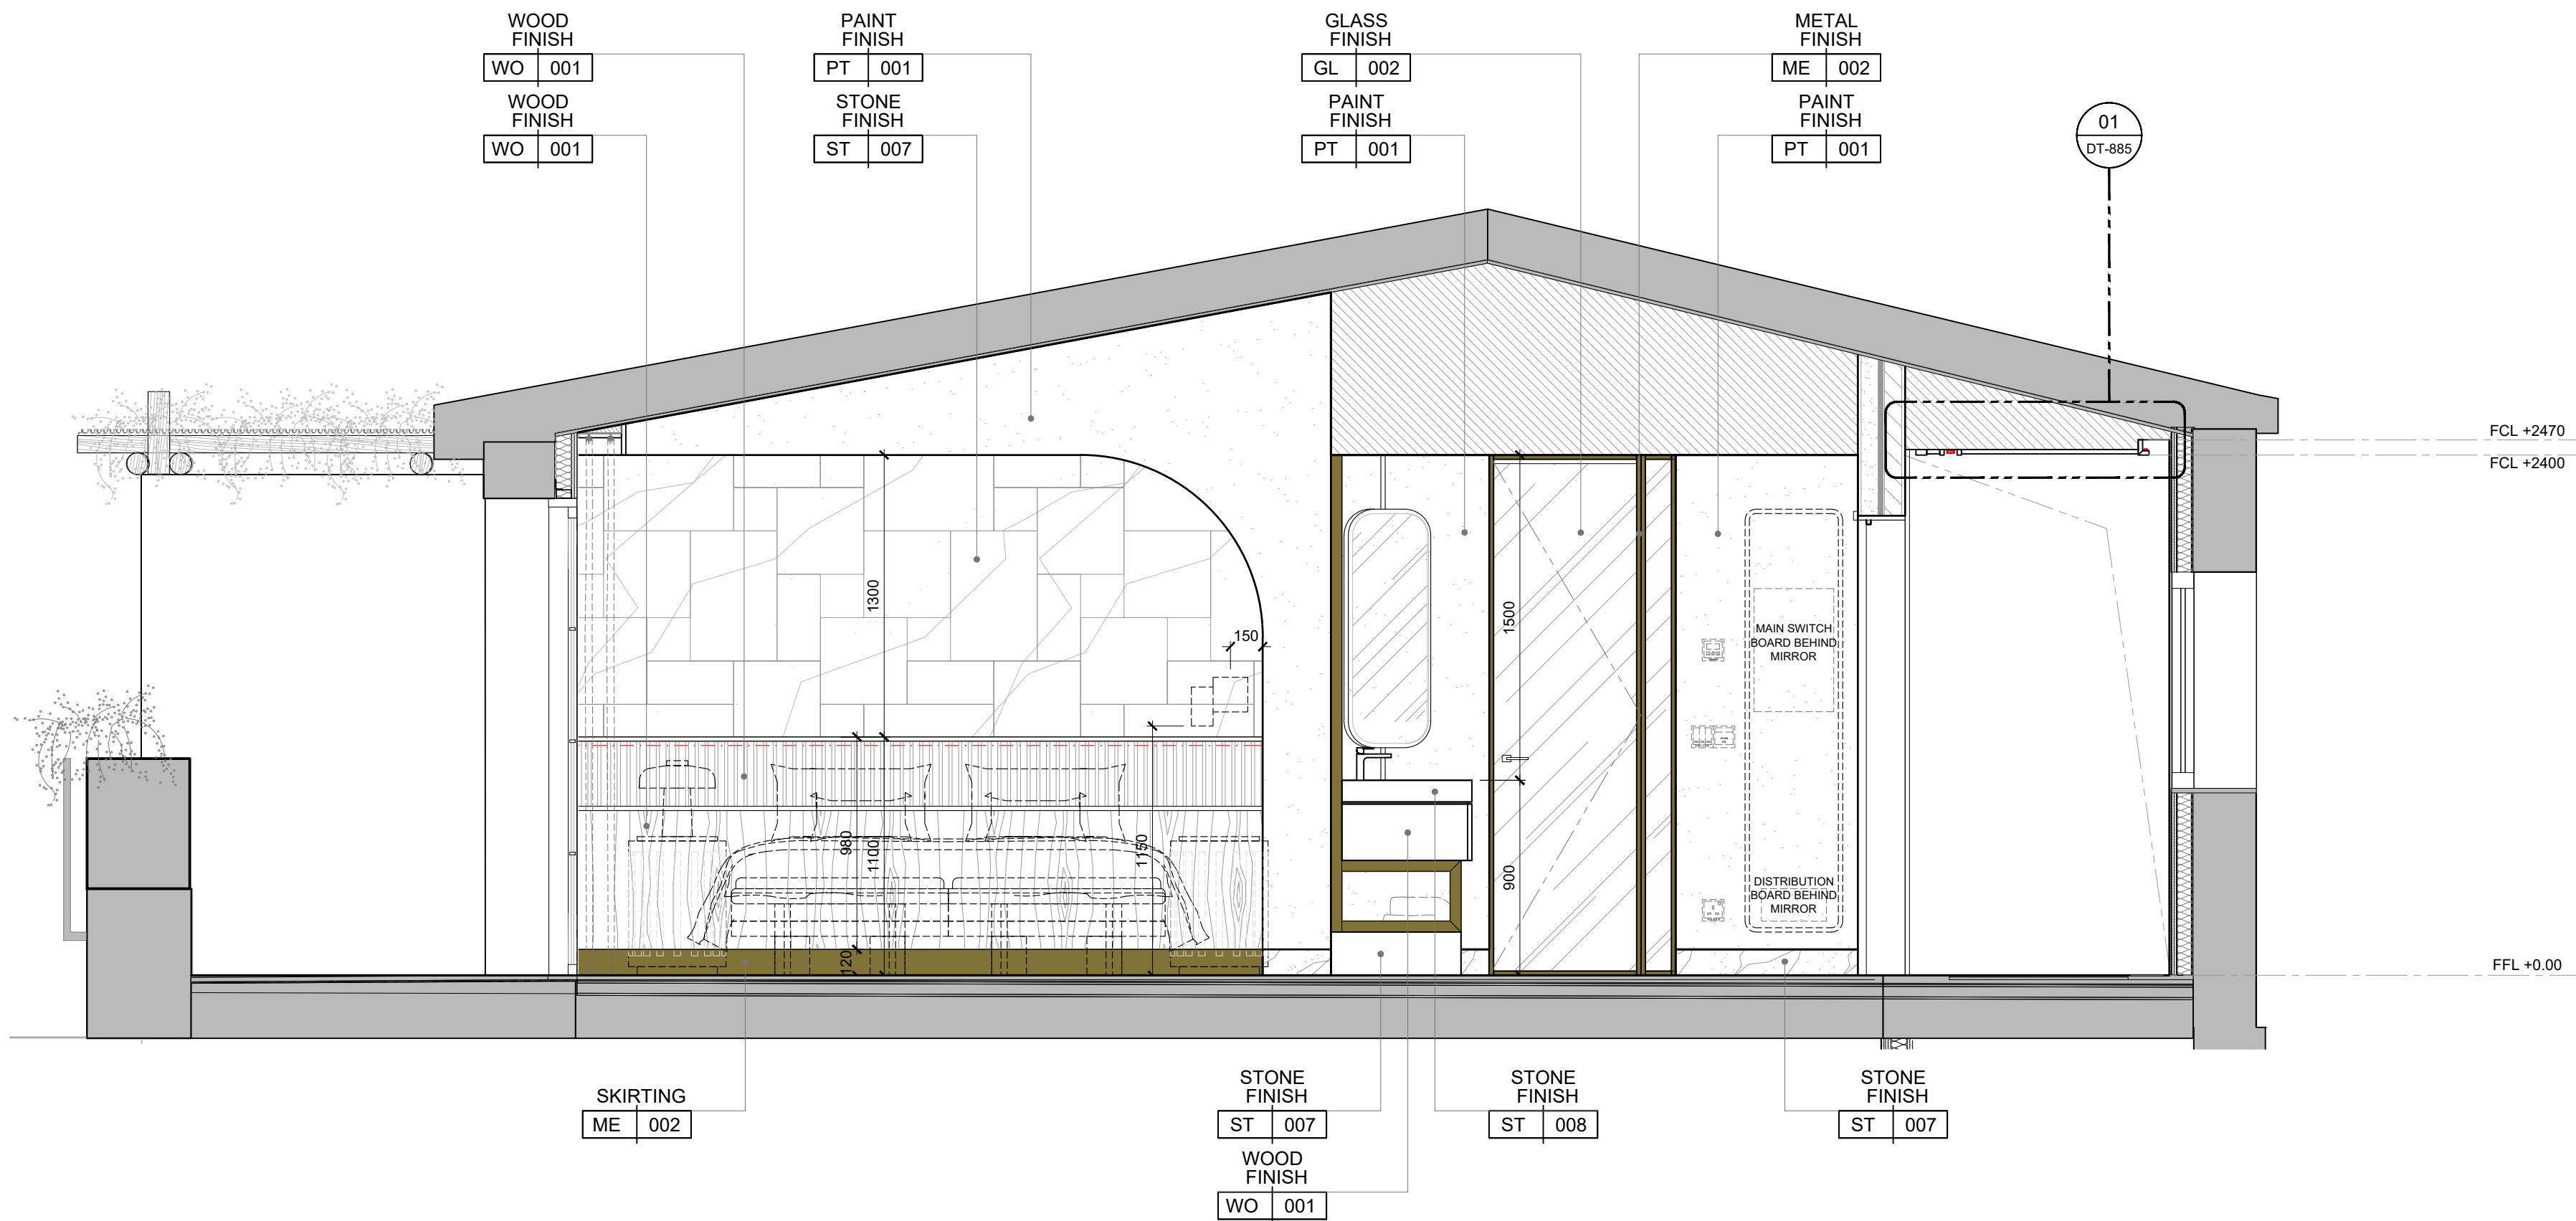

01

ELEVATION


SCALE 1:25 (A1) / 1:50 (A3)

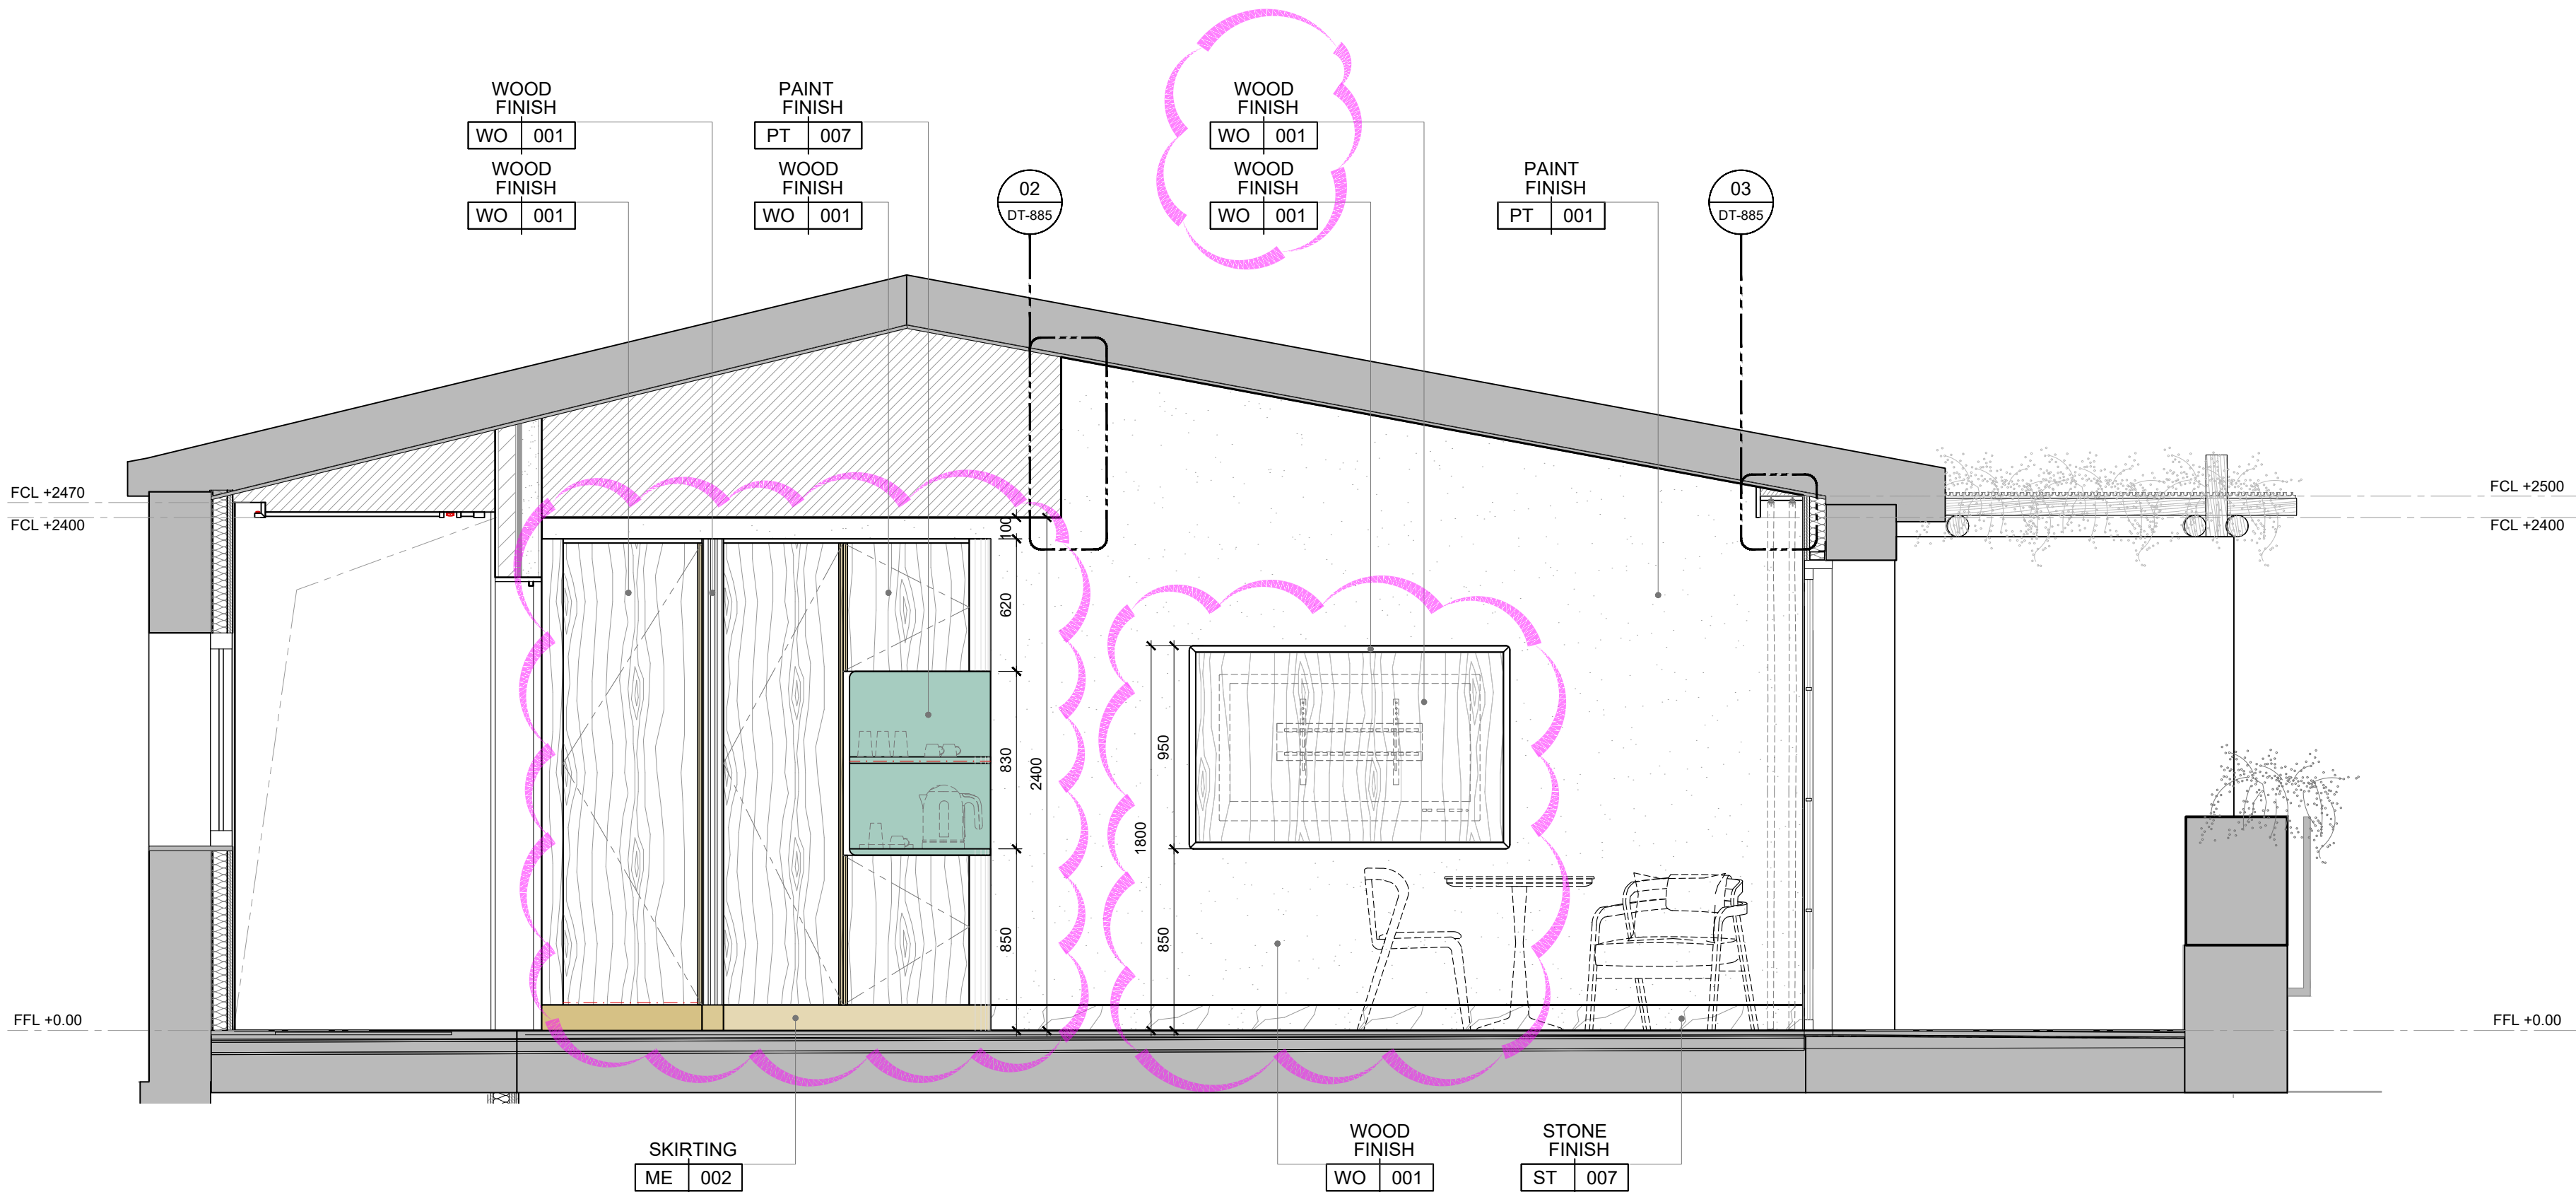

02

ELEVATION

SCALE 1:25 (A1) / 1:50 (A3)

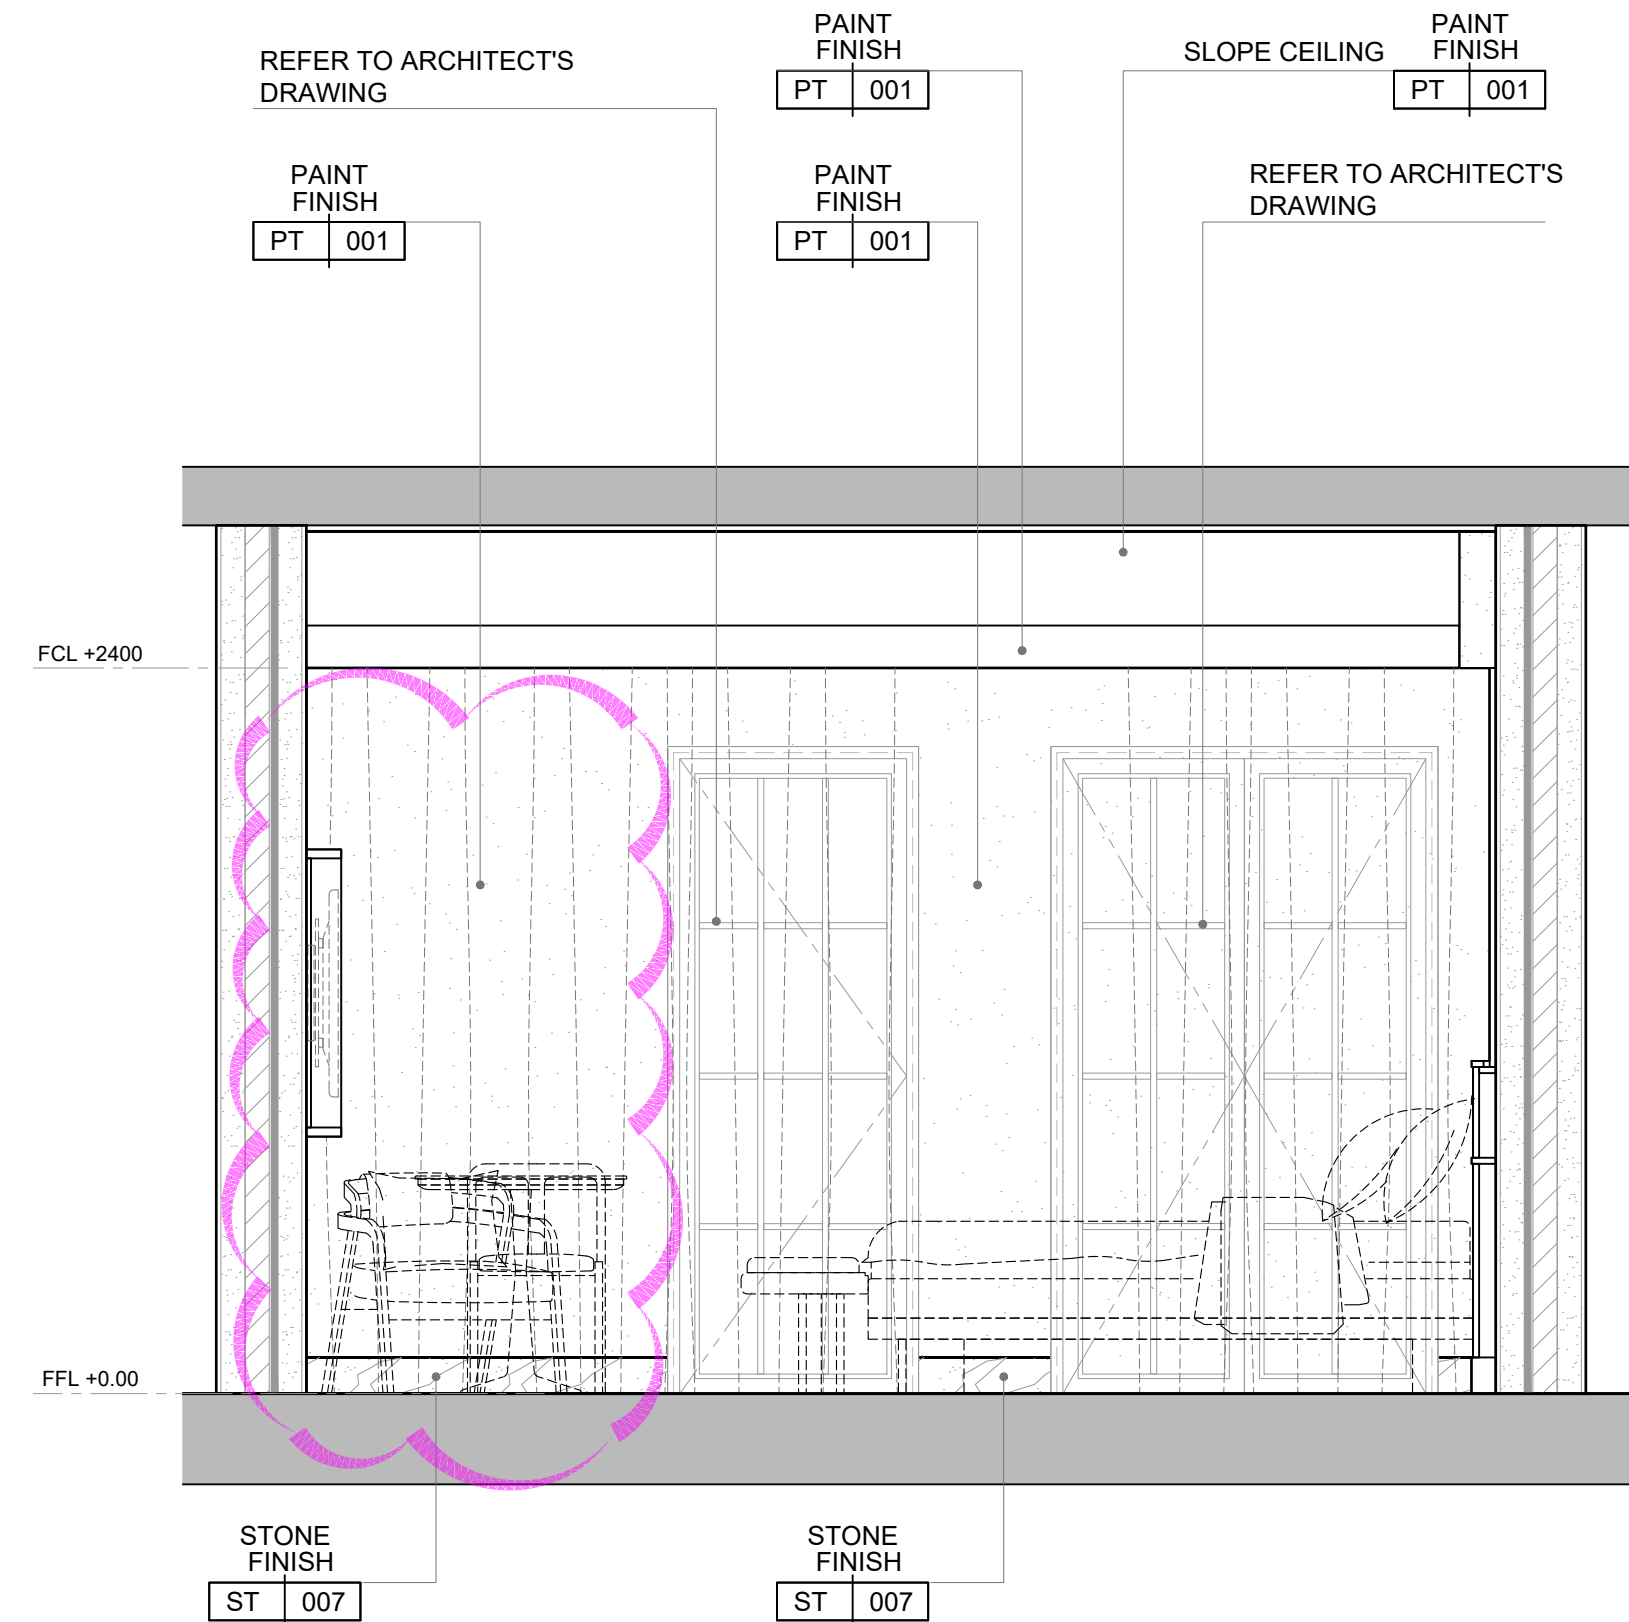

03

ELEVATION

SCALE 1:25 (A1) / 1:50 (A3)


GENERAL NOTES

DO NOT TAKE MEASUREMENT DIRECTLY ON THE DRAWING.
ANY DISCREPANCY BETWEEN THIS DRAWING AND OTHER INFORMATION
MUST BE REPORTED TO POD ARCHITECTURE.
FOR UNDER CONSTRUCTION OR EXISTING BUILDING, CONTRACTOR IS
REQUIRED TO VERIFY THE CORRESPONDENCE BETWEEN THE REAL
DIMENSIONS POINTED ON SITE AND THOSE LISTED ON THE DRAWING.
IN CASE OF DISCREPANCY BETWEEN THIS DRAWING AND APPROVED
DRAWINGS OF SUBCONTRACTOR, SUBCONTRACTOR'S DRAWINGS ARE
PRIORITY.
CONFLICT ARISING OUT OF THE INFORMATION AS INDICATED ABOVE
MUST BE REPORTED IMMEDIATELY TO POD ARCHITECTURE.
THIS DRAWING IS THE INTELLECTUAL PROPERTY OF POD
ARCHITECTURE.
DIMENSIONS ARE IN MILLIMETERS UNLESS OTHERWISE STATED.

NOTE:
ALL GENERAL DIMENSIONS ARE
INDICATIVE ONLY. PLEASE REFER TO
EXISTING SITE TO CHECK IF GIVEN
DIMENSIONS ARE APPLICABLE.
ADJUST TO FIT WHEN NECESSARY.

Legend

Keyplan

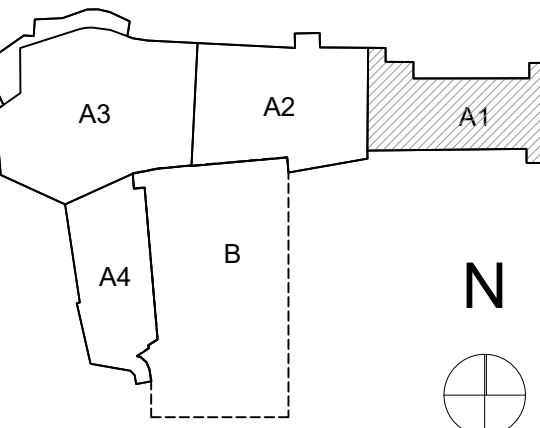

Proprietà

Smeralda Holding

Smeralda Holding Srl
Casa Il Ginepro Via
07021, Porto Cervo (OT)

Project Management

CUSHMAN & WAKEFIELD

Cushman & Wakefield
Via Filippo Turati, 10/18, 20121, Milano
Arch. Benedetta Albottori
Arch. Gianluca Di Cristofaro

Architect

LEV | Arch

Lev arch srl
Via Boccaccio 29 20123 Milano
Arch. Luca Colombo

Local Architect - Structural Engineer

Studio Ingegneria Cannas

Studio Ingegneria Cannas
Via Giorgio - Geocity torre 3, 07026, Olbia (SS)
Ing. Danilo Cannas

Fire - Acoustic Consultant

Acoustic Engineering s.r.l.

Acoustic Engineering s.r.l.
Corso Telesio, 107/a, 10149, Torino
Arch. Elenaletta Pignatelli
Ordine Ingegneri di Torino n. TQ04836AD1207

System Engineer

ITC engineering s.r.l.

ITC engineering s.r.l.
Via Benozzi, 6, 20122, Milano
Ing. Antonio Alberto Bazzoni Reggiani
Ordine Ingegneri di Milano n. 24543

Interior Designer

POD

Atelier POD
301 JLT Dubai UAE, PO 337416, Tel 0442127701
Laurine Hugel
Jean Luc Delar

Le basi del disegno derivano dai seguenti documenti: *Tennis club drawings starting points* are
Base grafica degli esterni: Rilievo del 2004; *Exterior drawings: 2004 Survey*;
Base grafica dell'edificio: Stato di Fatto Ing. Cannas del 17/07/2023; *Building drawings: 17/07/2023 As Built from Ing. Cannas*;
Base grafica di quote e info interne all'edificio: Sanatoria Ing. Cannas del 23/07/2022 e rilievo 09/2023
Interior and exterior levels: 23/07/2022 amnesty from Ing. Cannas + 09/2023 survey
NB. Le quote di livello del rilievo 2004 (xxx) differiscono dalle ultime del rilievo 2023 (xxx) di circa 1, 30mt
Levels from 2004 survey (xxx) and the last from 2023 survey (xxx) differs by 1, 30mt



MOCK-UP ROOM DETAIL DESIGN
First Floor Guestroom 103

Project

Cervo Tennis Club

Manzoni
Arzachena

Site
Via Porto Vecchio, 4
Porto Cervo 07021

Sheet Title

GUESTROOM MUR ELEVATIONS

Scale
AS SHOWN

No. Drawing
CTC_MOC_ID_PJ_700_A1

digital file index

CTC_MOC_ID_PJ_700_A1 Elevations.dwg

Date
2024.02.20

Format
A1

Revision

Rev.	Date	Revis.	By	Check	Appr.
A	2024.02.20	DD P1 - FIRST ISSUE	LH	KM	-
B	2024.03.01	DD P1 - SECOND ISSUE	LH	KM	-
C	2024.03.22	DD P1 - THIRD ISSUE	LH	KM	-
D	2024.05.03	DD P1 - FOURTH ISSUE	LH	KM	-
E	2024.09.27	DD P1 - FIFTH ISSUE	LH	KM	-

ATLIER
POD

Dubai-Paris-Casablanca
www.stellerpod.com